


MARK	DATE

DATE:	09/27/10
JOB:	042710
FILE:	A2.01(E)
DRAWN:	JEE
CHECKED:	BJT


COPYRIGHT
 BAMBOO REVOLUTION 2010

**BASEMENT
 PLAN
 (EXISTING)**

A2.01(E)

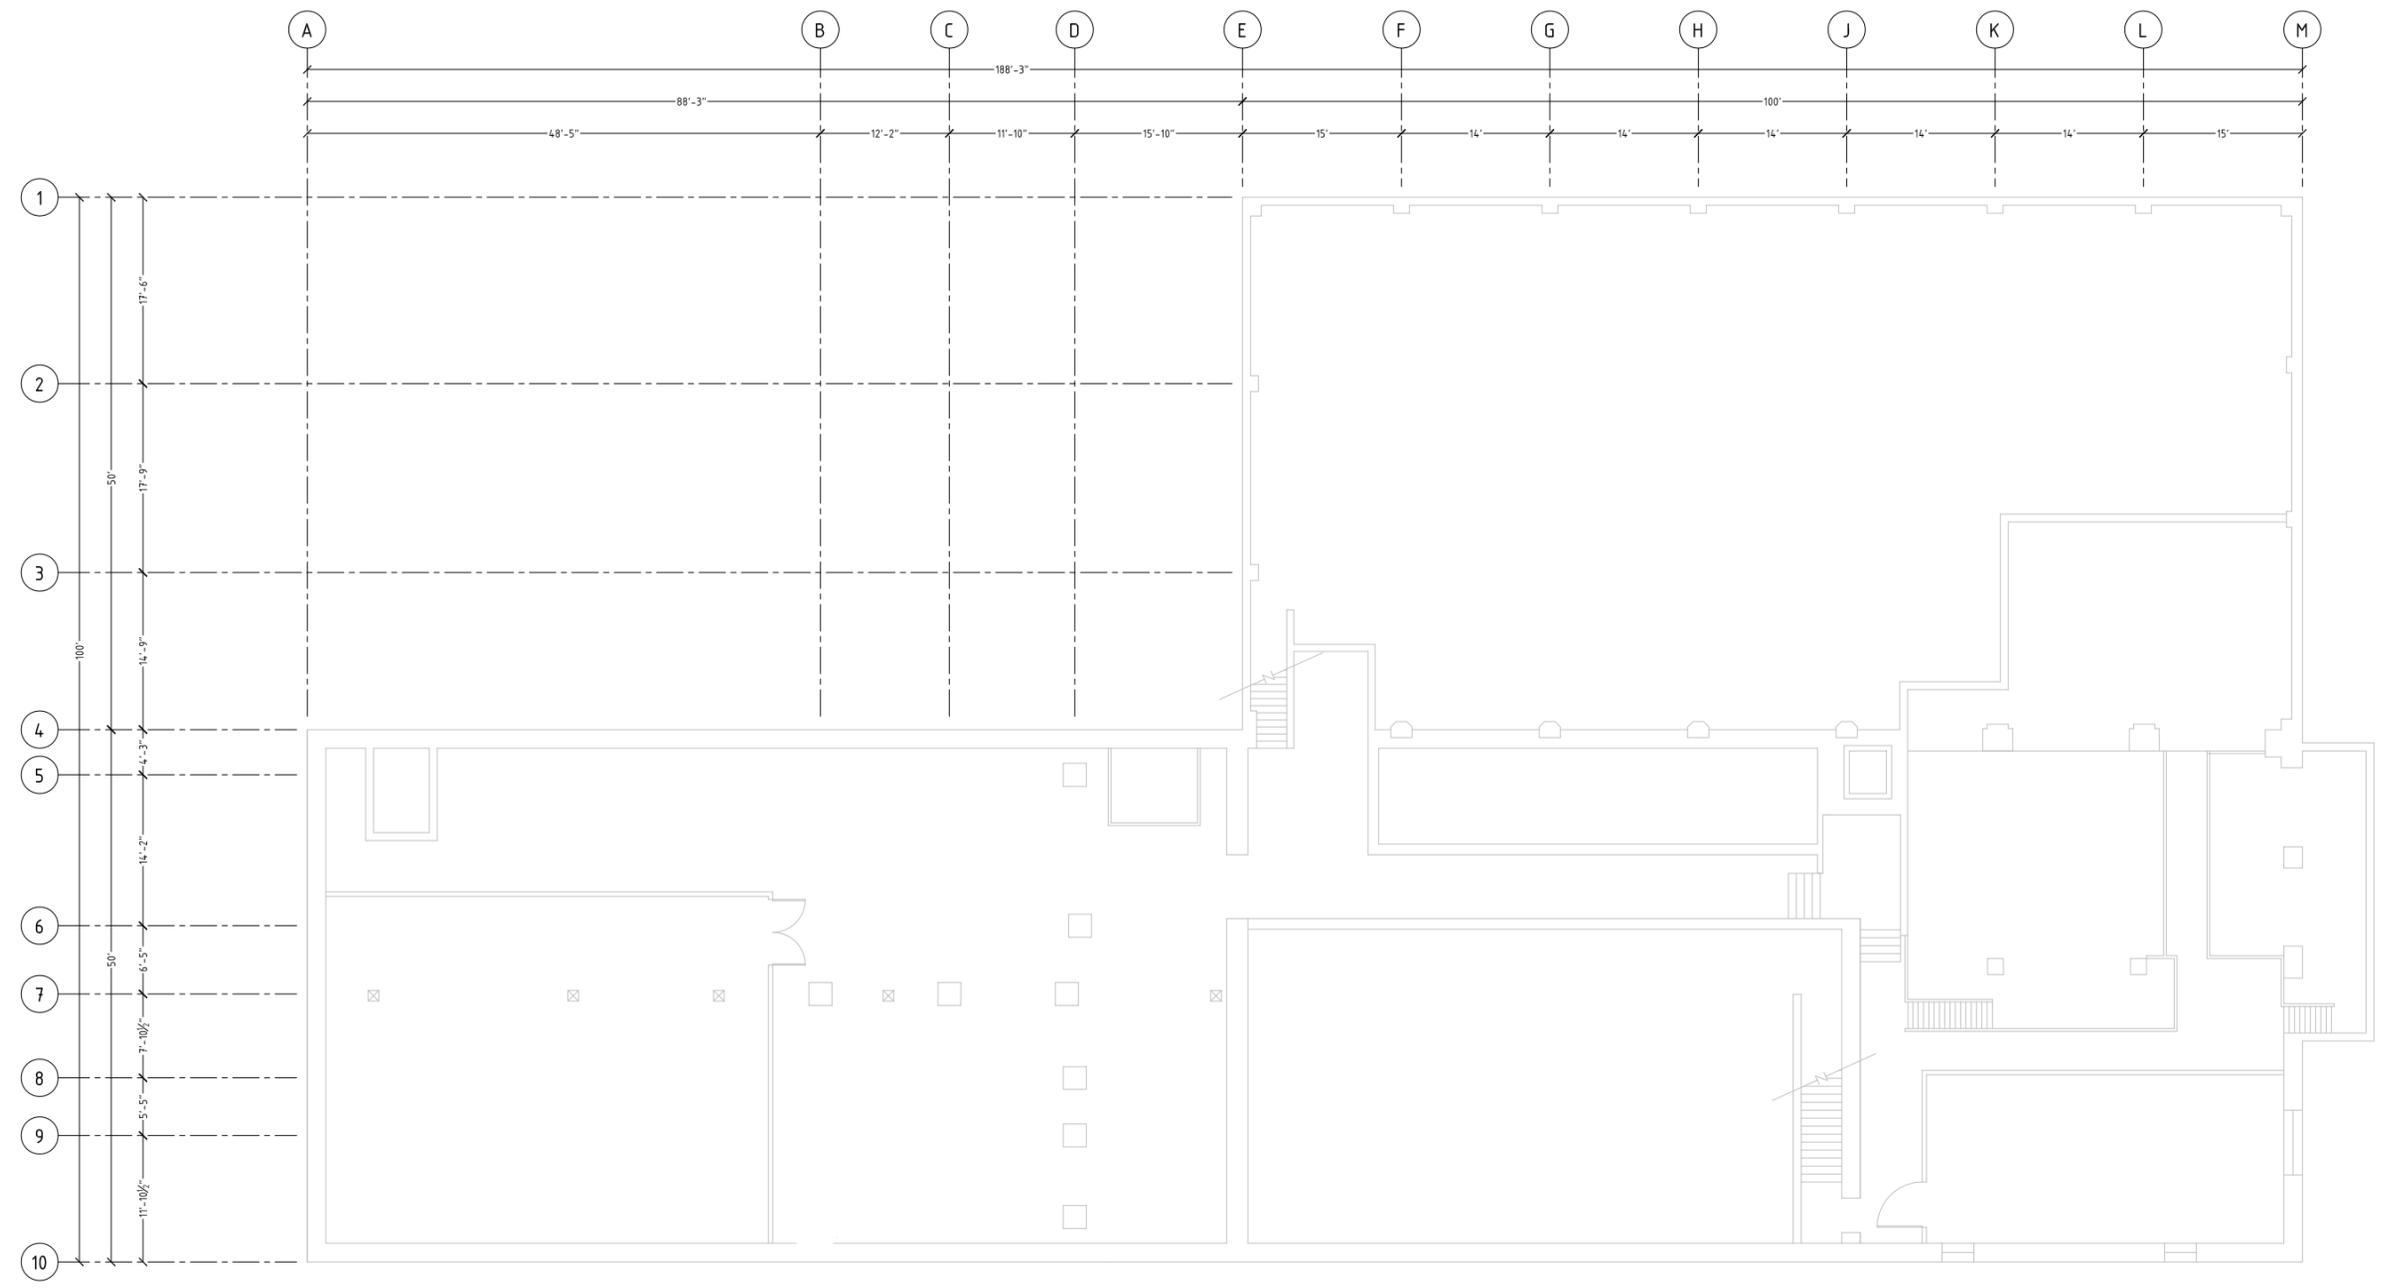

1
A2.01 **BASEMENT PLAN (EXISTING)**
 1/8" = 1'-0"

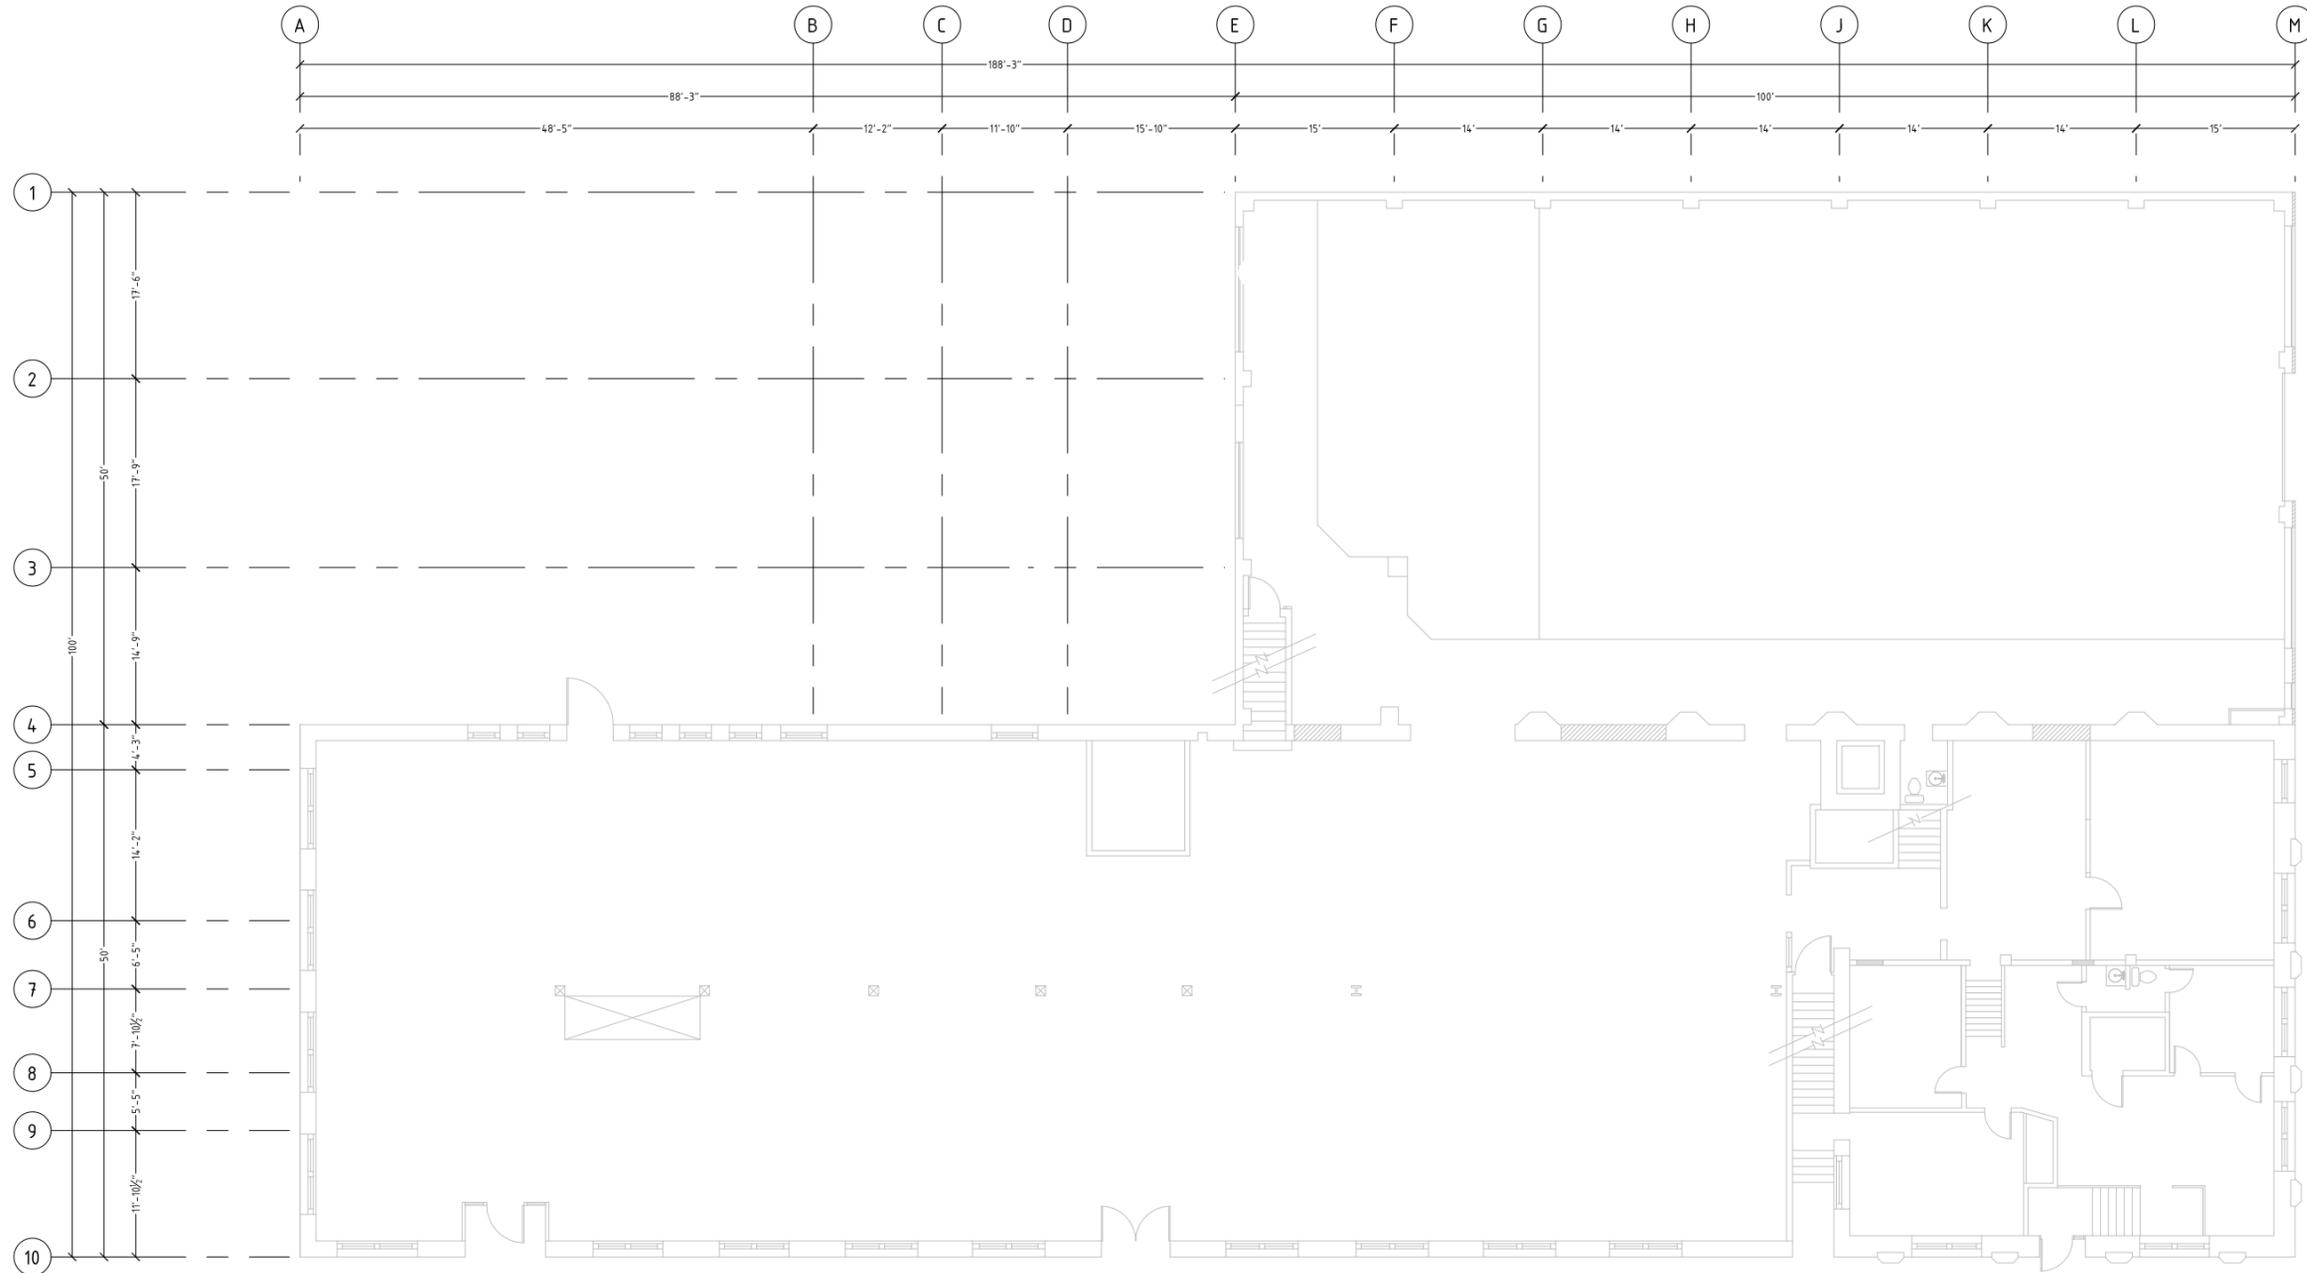

1 1ST FLOOR PLAN (EXISTING)
 A2.02 1/8" = 1'-0"




MARK	DATE

DATE:	09/27/10
JOB:	042710
FILE:	A2.02(E)
DRAWN:	JEE
CHECKED:	BJT

COPYRIGHT
 BAMBOO REVOLUTION 2010

1ST FLOOR
 PLAN
 (EXISTING)

A2.02(E)

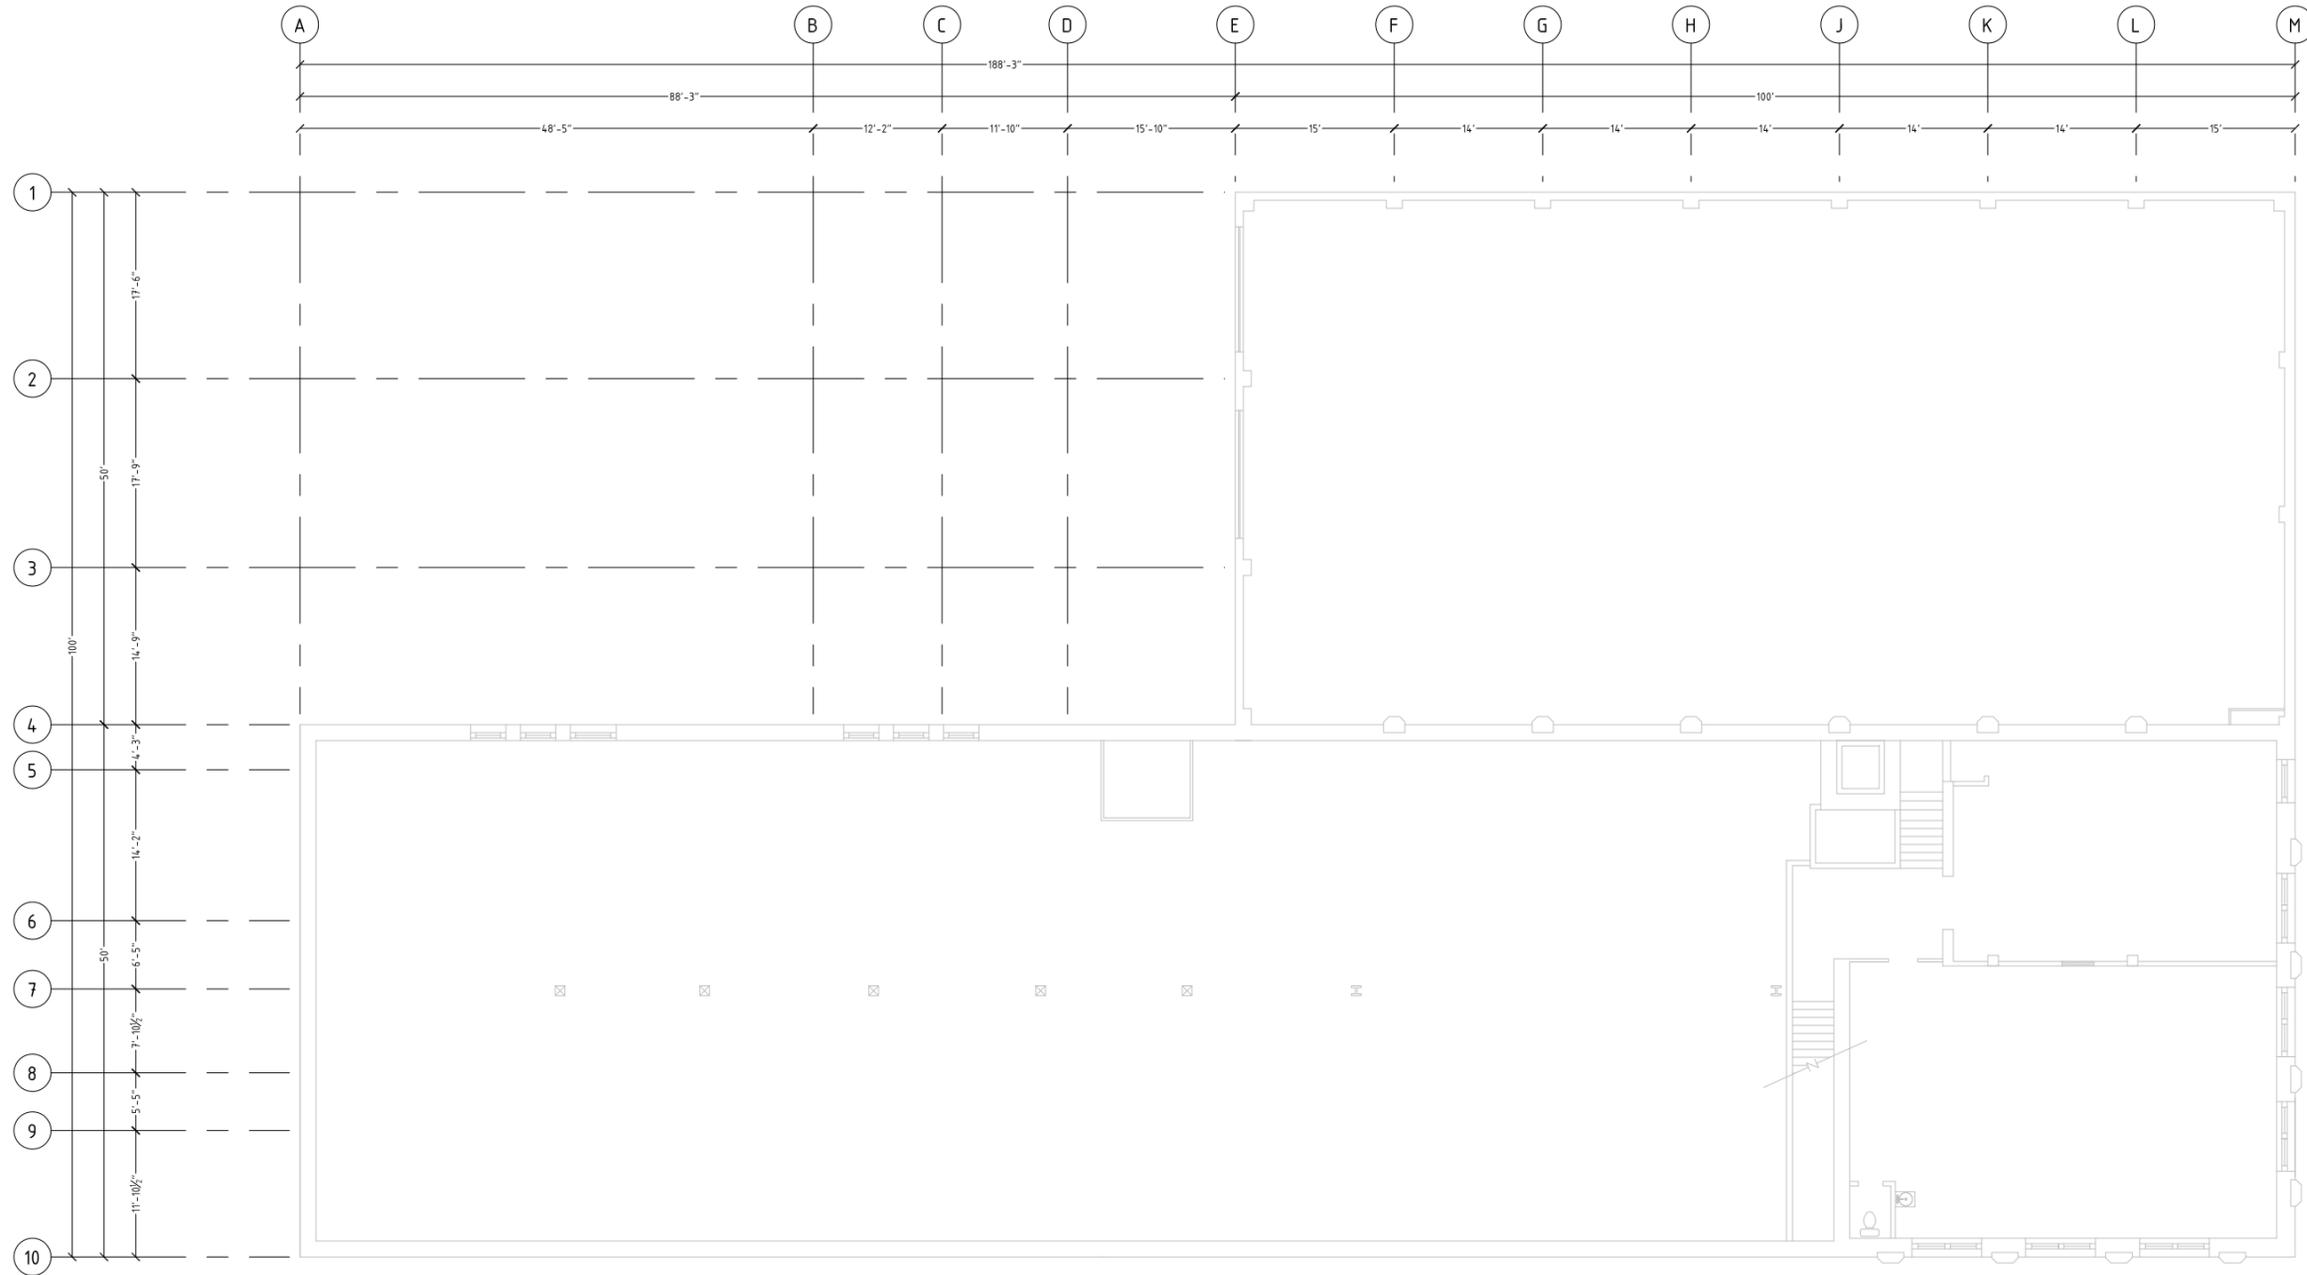

1
A2.03

MEZZANINE PLAN (EXISTING)

1/8" = 1'-0"



YU
800 SE 10th Avenue
Portland, Oregon 97214


MARK	DATE

DATE:	09/27/10
JOB:	042710
FILE:	A2.03(E)
DRAWN:	JEE
CHECKED:	BJT

COPYRIGHT
BAMBOO REVOLUTION 2010

MEZZANINE
PLAN
(EXISTING)

A2.03(E)

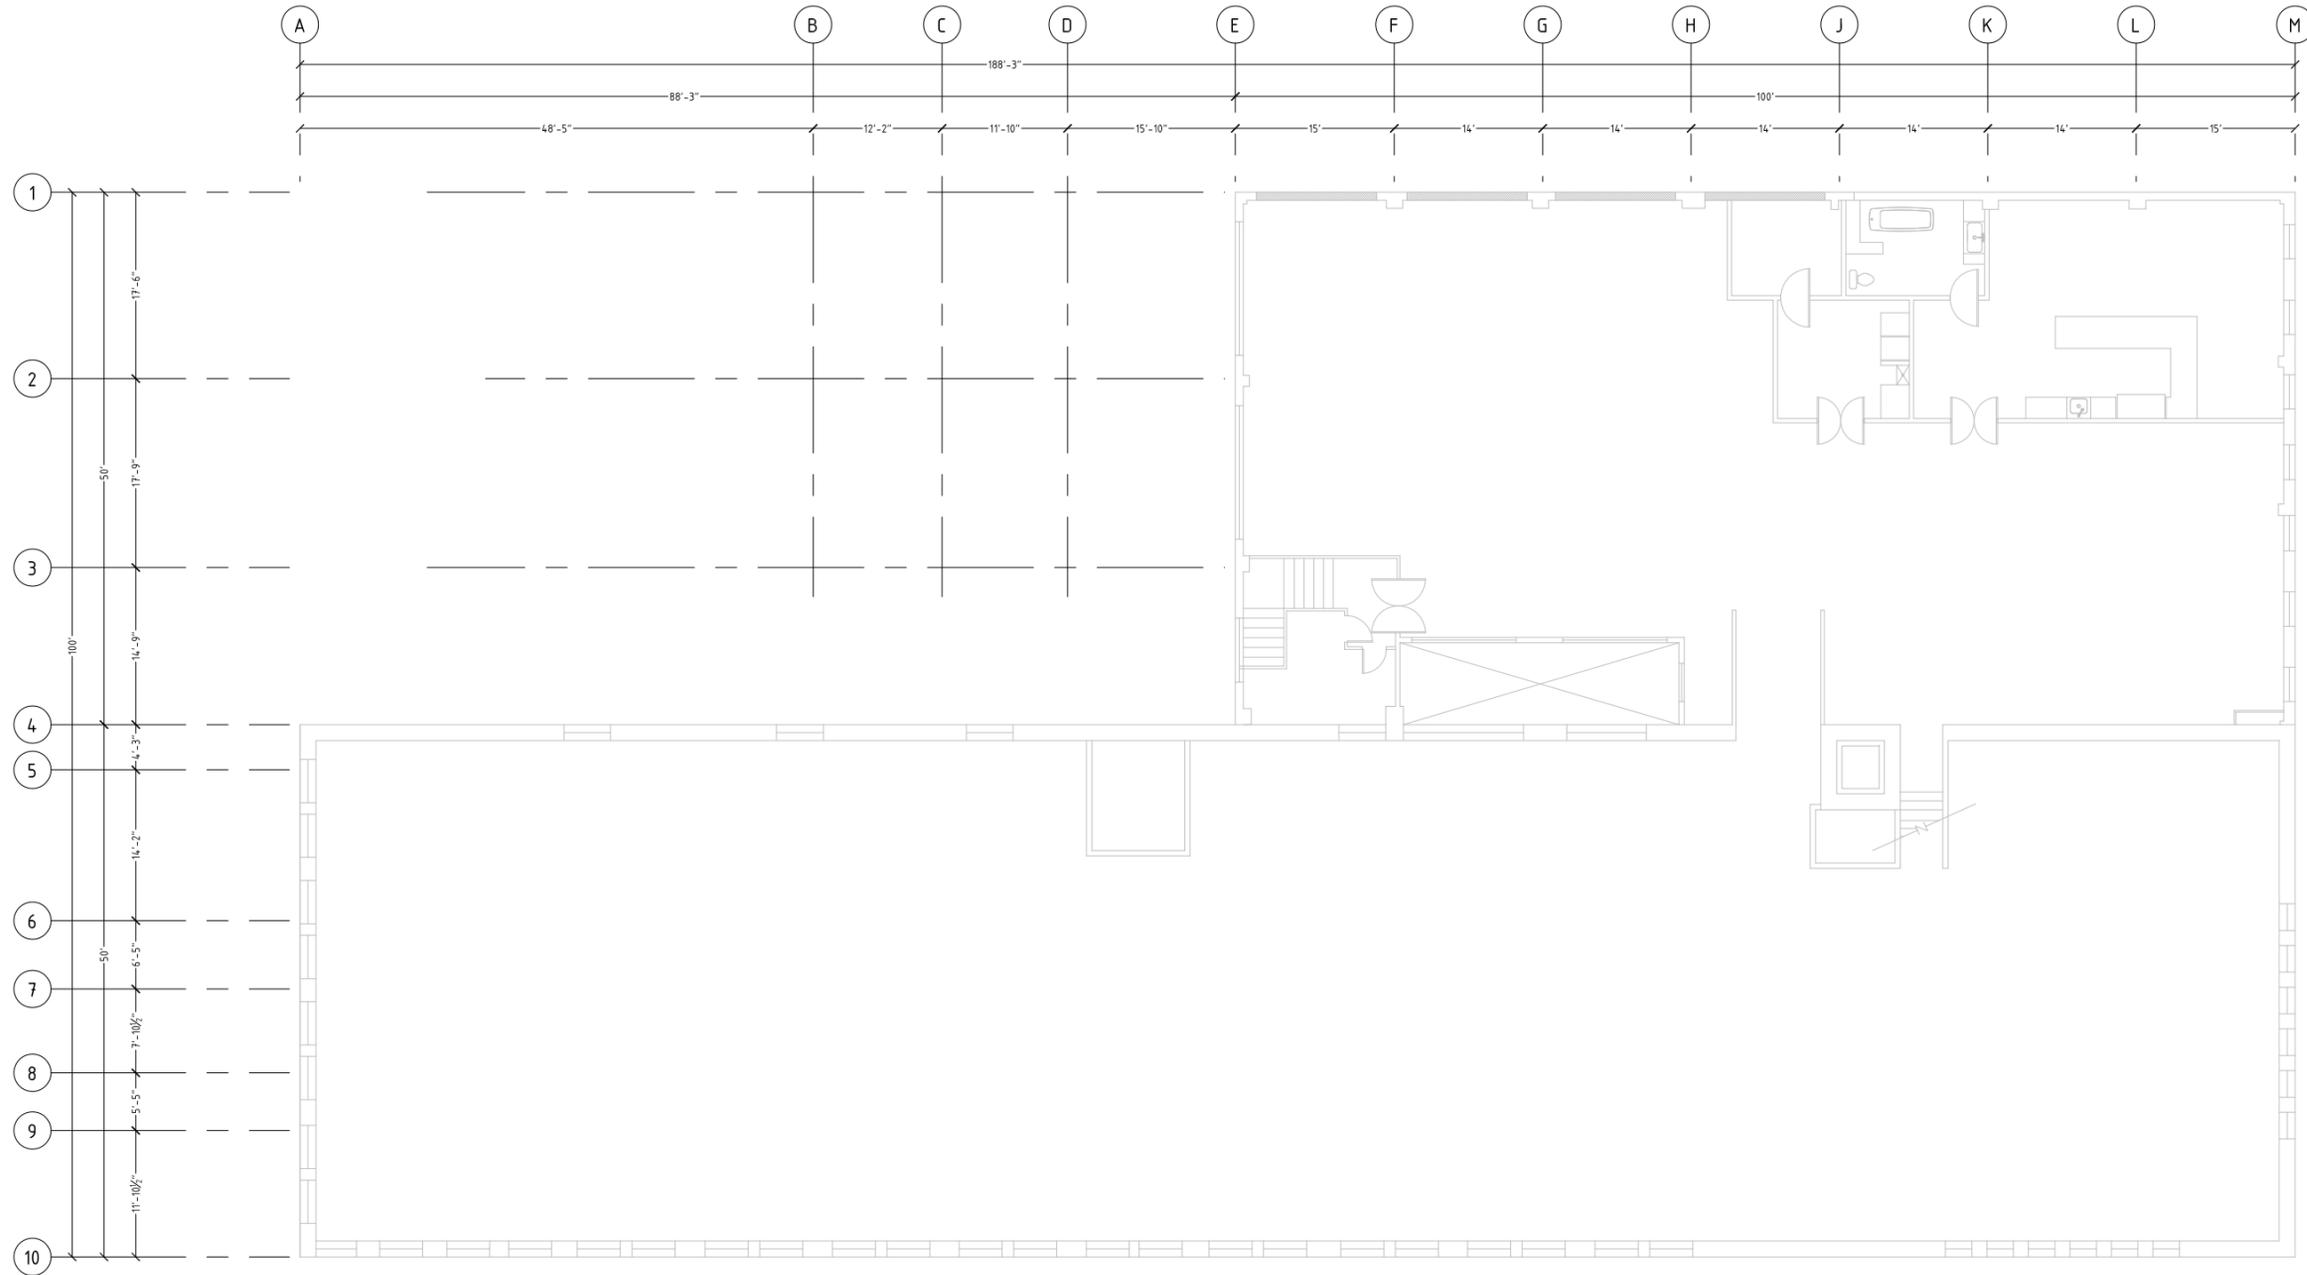

1
A2.04

2ND FLOOR PLAN (EXISTING)

1/8" = 1'-0"



YU
800 SE 10th Avenue
Portland, Oregon 97214


MARK	DATE

DATE:	09/27/10
JOB:	042710
FILE:	A2.04(E)
DRAWN:	JEE
CHECKED:	BJT

COPYRIGHT
BAMBOO REVOLUTION 2010

2ND FLOOR
PLAN
(EXISTING)

A2.04(E)

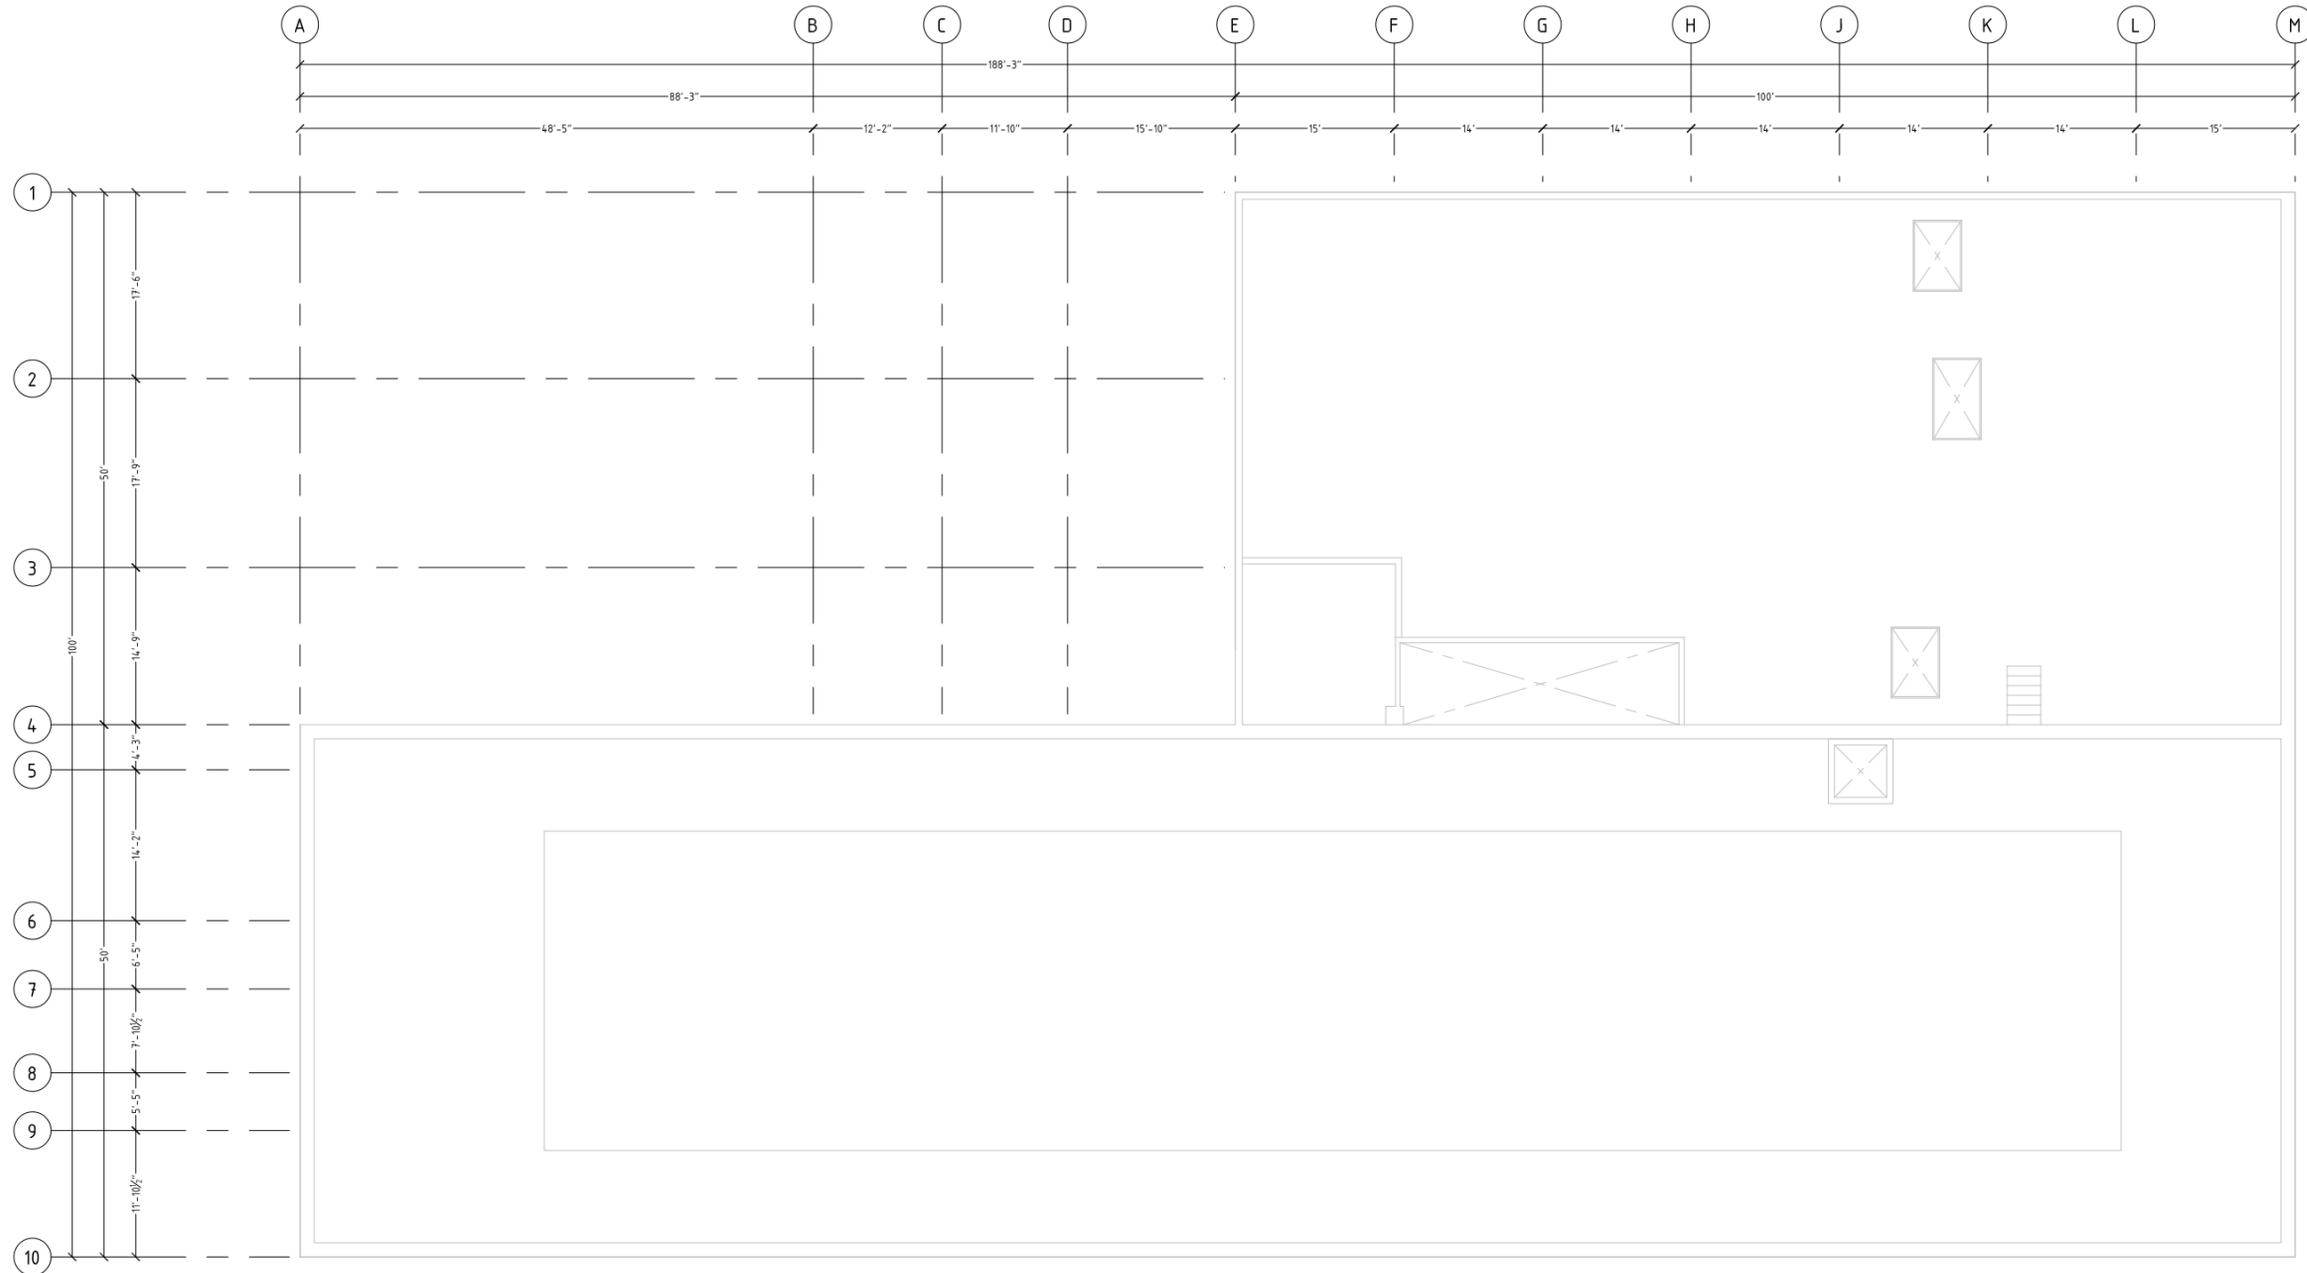

1
A2.05

ROOF PLAN (EXISTING)

1/8" = 1'-0"



YU
800 SE 10th Avenue
Portland, Oregon 97214

MARK	DATE

DATE:	09/27/10
JOB:	042710
FILE:	A2.05(E)
DRAWN:	JEE
CHECKED:	BJT

COPYRIGHT
BAMBOO REVOLUTION 2010

ROOF PLAN
(EXISTING)

A2.05(E)